
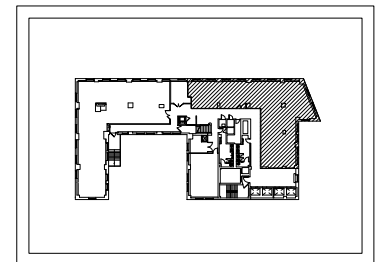


25th FLOOR

| SUITE 2507 | 4,726 RSF |
|--------------------------------|-------------------|
| CATEGORY | QUANTITY AS SHOWN |
| OFFICE | 7 |
| WORKSTATION INCL. RECEPTIONIST | 6 |
| TOTAL | 13 |
| RECEPTION | 1 |
| CONFERENCE ROOM | 1 |
| PANTRY | 1 |
| COPY | 1 |
| IT | 1 |
| COAT | 1 |

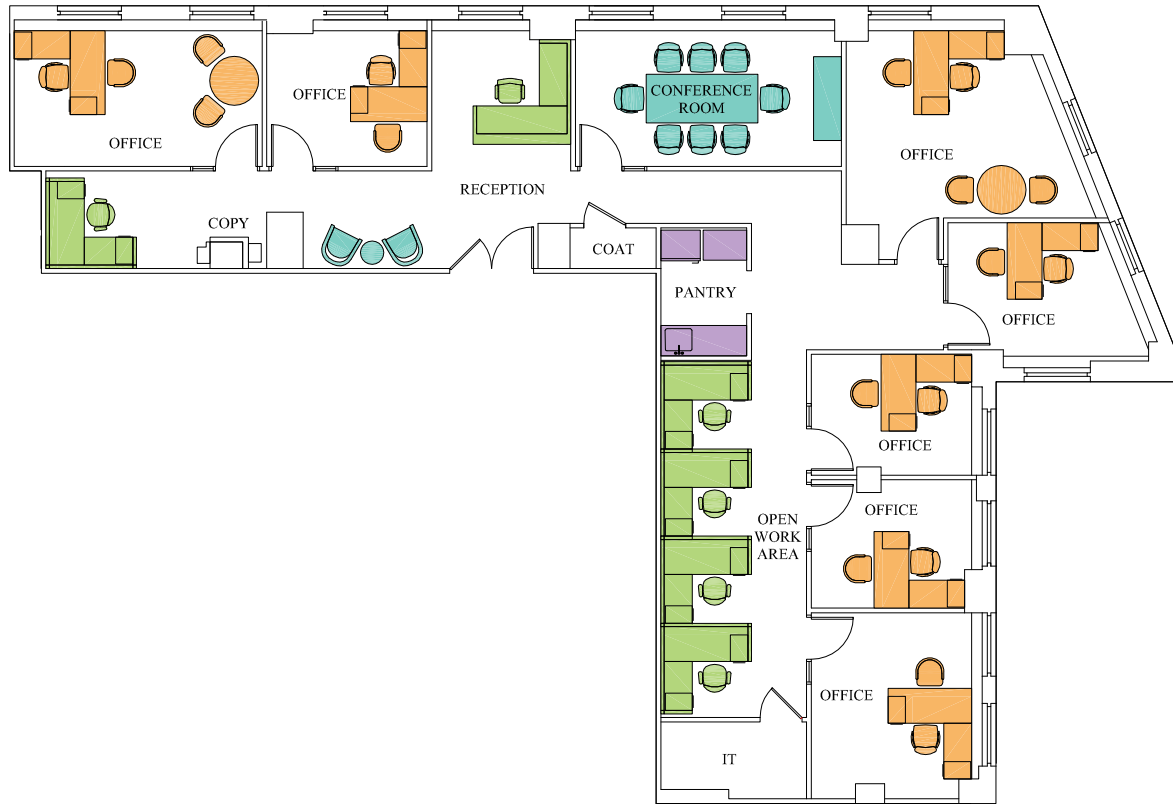

250 WEST 57TH STREET

250 W 57TH ST

250 WEST 57TH STREET
NEW YORK, NY 10107

SUITE 2507

4,726 RSF

AS-BUILT
11/11/19

EMPIRE STATE

REALTY TRUST

empirestaterealtytrust.com

ESRT
LISTED
NYSE

Member
REBNY
REAL ESTATE BOARD OF NEW YORK