
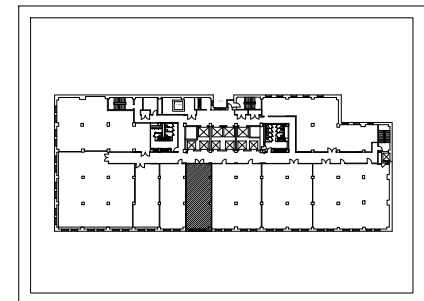


## 4TH FLOOR

SUITE 406	1,609 RSF
CATEGORY	QUANTITY AS SHOWN
OFFICE	3
WORKSTATIONS	2
TOTAL	5

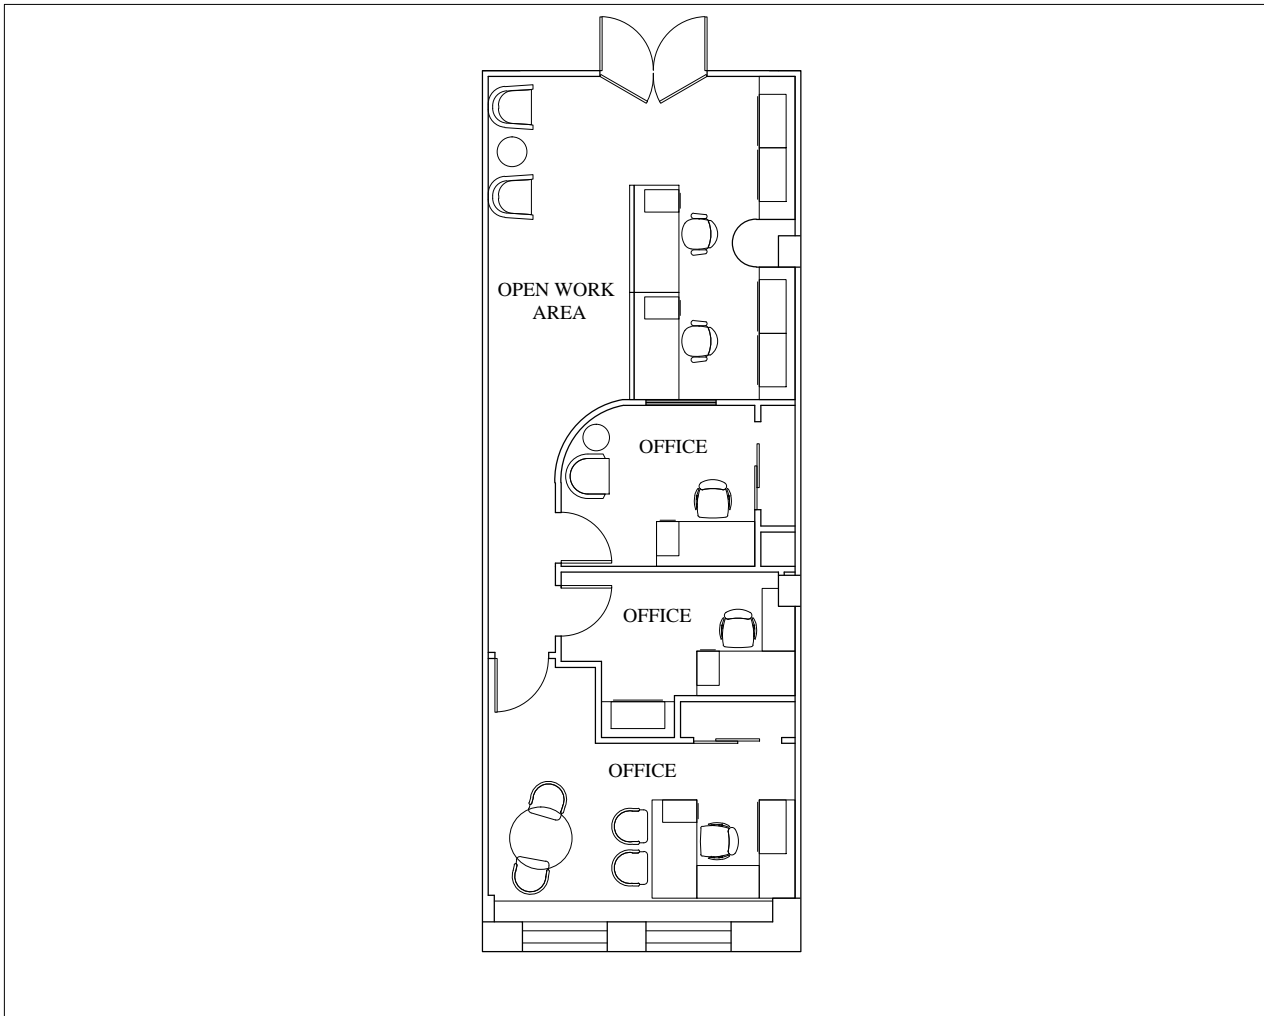

# 501 7TH AVENUE

501 7TH AVENUE  
NEW YORK, NY 10018

SUITE 406 1,609 RSF

AS-BUILT

11/29/17

**EMPIRE STATE**  
REALTY TRUST  
[empirestaterealtytrust.com](http://empirestaterealtytrust.com)

ESRT  
LISTED  
NYSE

Member  
**REBNY**  
REAL ESTATE BOARD OF NEW YORK